


CO-OP MINING CO.
HUNTINGTON, UTAH

HYDROLOGY MAP

SCALE: 1" = 50'
DRAWN BY: C. Reynolds
DATE: 6-25-01

BEAR CANYON PLATE 7-1F

REV.	DATE	REMARKS	APPR.
1	6/25/01	Wild Horse Ridge Hydrology Added (SR98-1)	7/03/01
2	8/01/02	Digitize Map	
3	5/09/06	WHR Tank Seam As-Built/Snow Storage	8/22/07
4			
5			
6			
7			
8			
9			
10			

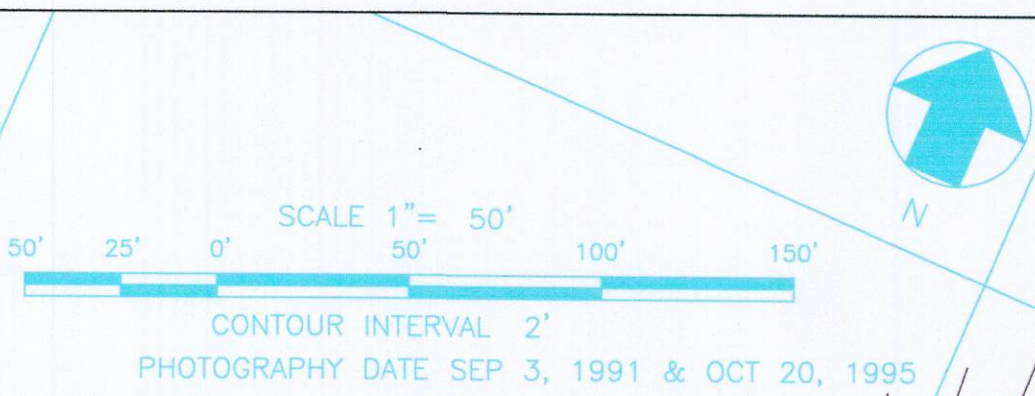

LEGEND

PERMIT BOUNDARY
DISTURBED AREA
PRE-1977 DISTURBANCE
CULVERTS

CONTOUR LINE
UNPAVED ROADS
SECTION LINE
SEE PLATES 7-1 FOR HYDROLOGY

PAVEMENT
WATER LINES
DRAINAGE
POWER POLES
STREAM BUFFER ZONE MARKERS

